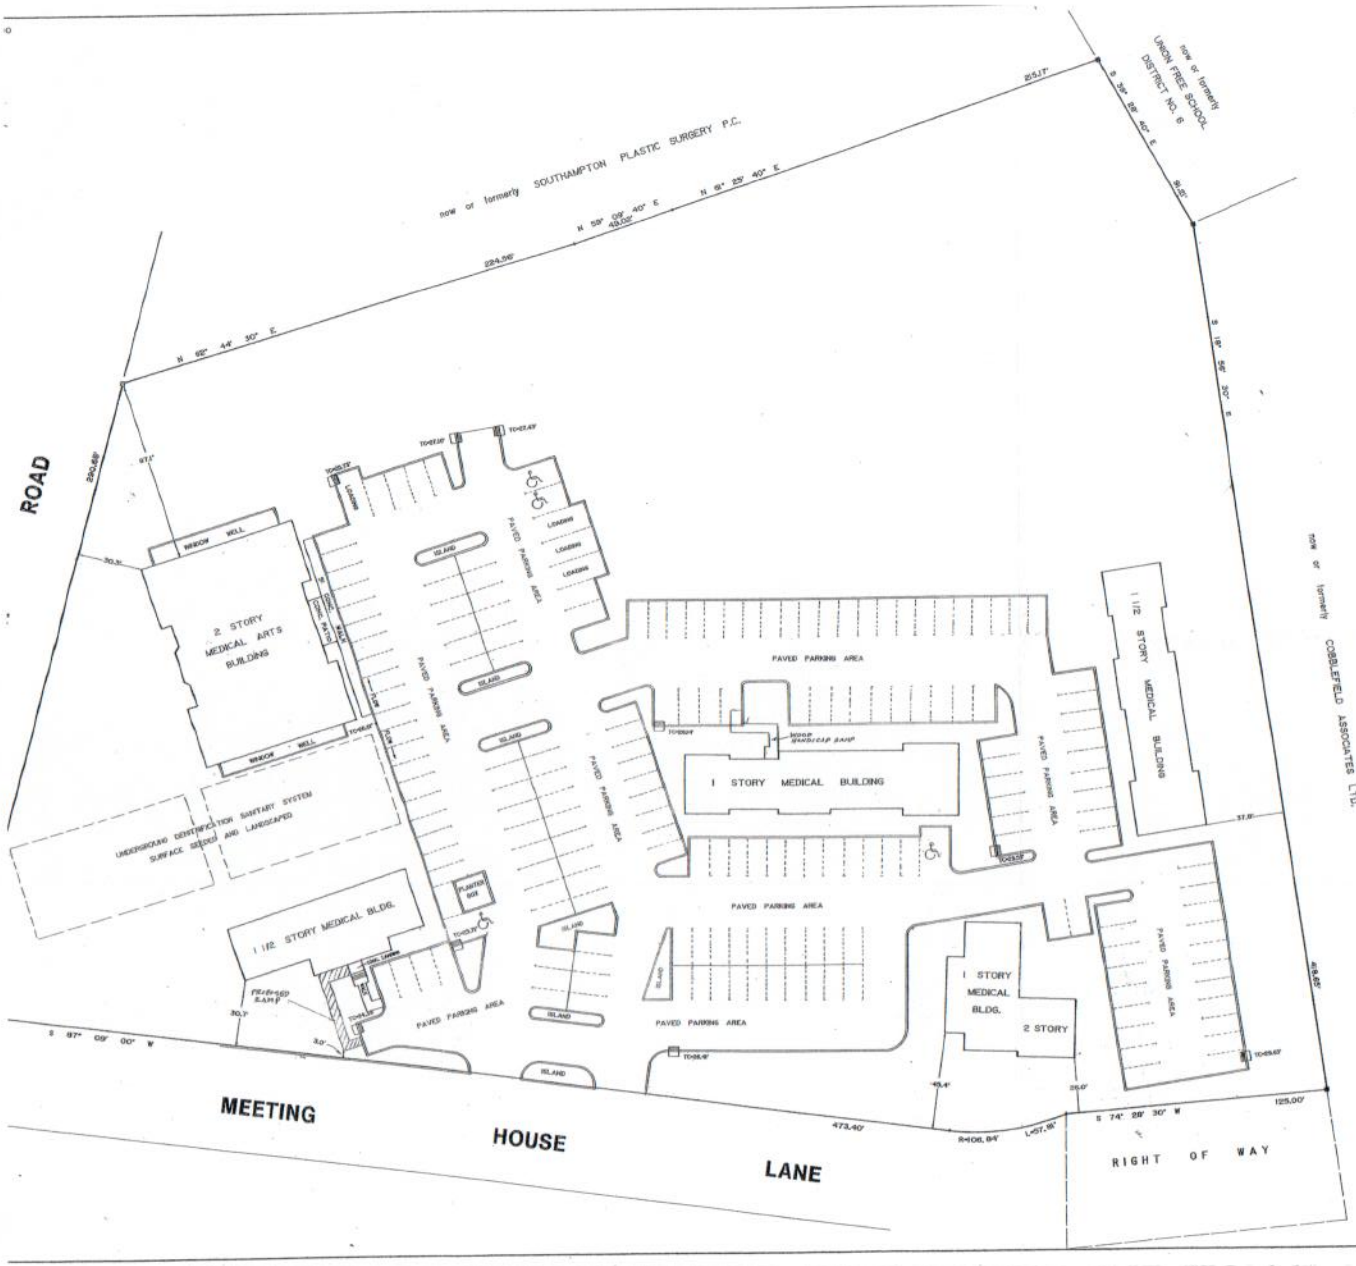

AS BUILT SURVEY
FOR
OLD TOWNE MEDICAL VILLA(
SITUATE
INC. VILLAGE OF SOUTHAMPTON
TOWN OF SOUTHAMPTON
SUFFOLK COUNTY, N.Y.

AREA= 5.474 ACRES

	SQUIRES, HOLDEN, WEISENBACHER & LAND SURVEYORS ENGINEERS SOUTHAMPTON, NEW YORK		
	SCALE 1" = 30'	DATE	REV
		MAR. 12, 1981	AS BUILT PARKIN MEDICAL ARTS BI PROPOSED RAM AS BUILT INCORP EDITED AND CH